



## City of Orono 2018 Street Improvements Forest Lake Landing Design Change

July 5th, 2018

Dear Property Owner:


The City Council has provided preliminary guidance for a change in scope to the Forest Arms Landing portion of this summer's road project. The change includes transitioning the project from a pavement maintenance project to a reconstruction with concrete curbs, and an expansion of the pavement area at the end for easier turn arounds. The addition of concrete curbing and additional pavement also necessitates some additional stormwater piping.

While these changes will not drastically alter the construction process they will change the look and function of the final road project. The drawing below depicts the changes. The concrete curbing is in red and the stormwater pipes and catch basins in blue.

The change order will be presented to the City Council at their July 23<sup>rd</sup> meeting for formal approval. If you have any questions or concerns about the proposed changes please contact me at [aedwards@ci.orono.mn.us](mailto:aedwards@ci.orono.mn.us) or contact the project hotline listed below.

Sincerely,

Adam Edwards, P.E.  
Director of Public Works/City Engineer

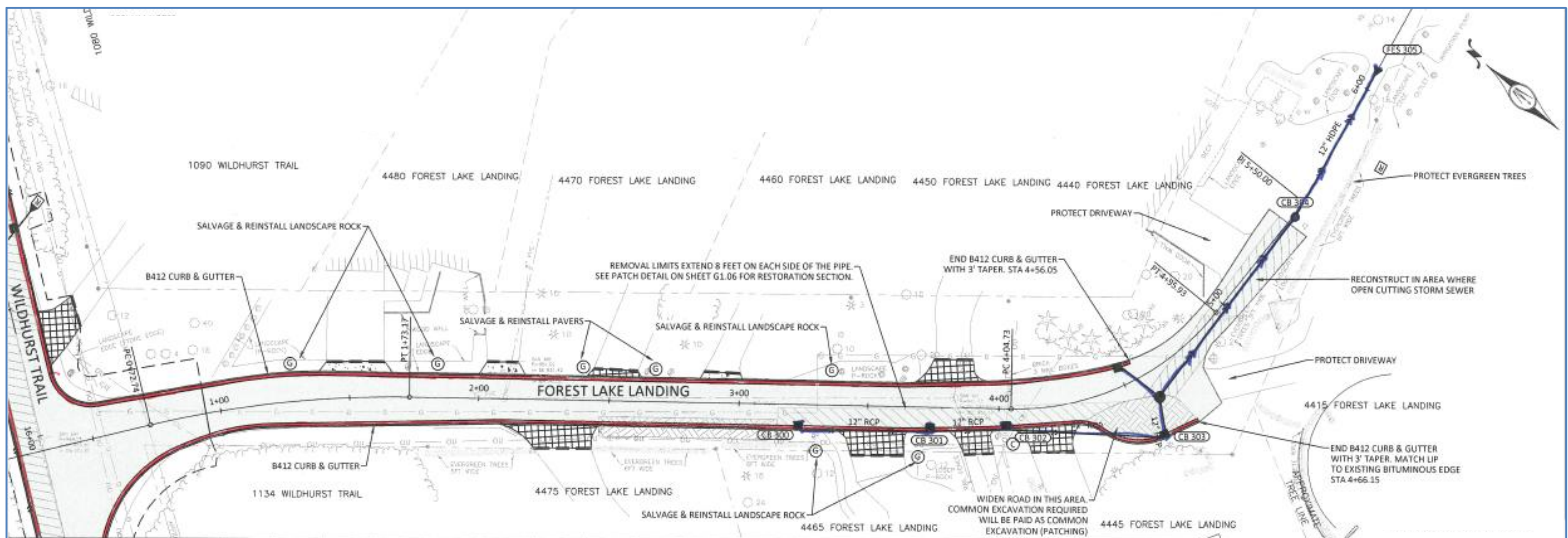

Project Hotline  
(612) 554-5855



2018 Street Improvements Email Updates  
City website → City Projects → 2018 → Email Update Sign Up